


Project
DANET ABU DHABI
 PLOT No. 43
 ABU DHABI
 UNITED ARAB EMIRATES

Client

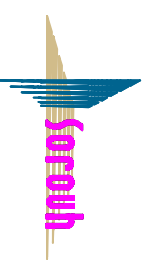

1st floor - 1st floor - Plot No. 43, Abu Dhabi - Abu Dhabi
 (Country Name, City Name)

Client Project No.:

Project manager:

NES
 شركة نيس
 "NESA ENGINEERING SERVICES" PO BOX 150184 FZC/ASHRAH/INDUSTRIAL STRIP

Consultants

ZNA
 ZENBERKOGUJ NAYMAN ASSOCIATES, INC.
 ARCHITECTS, INTERIORS DESIGNERS



C R J I A
 CAROL R. JOHNSON ASSOCIATES INC.

Main contractor:

NPC
 NPC-BCEG JV

Concrete wall

Water proof wall



HR FIRE RATED WALL

RFR FIRE RATED WALL

AS BUILT
FLAT NO.1

Scale	N.T.S	Date	28/10/09
Drawn	M.Fahad	Checked	Amjed
Drawing Title:			

Drawing Number:

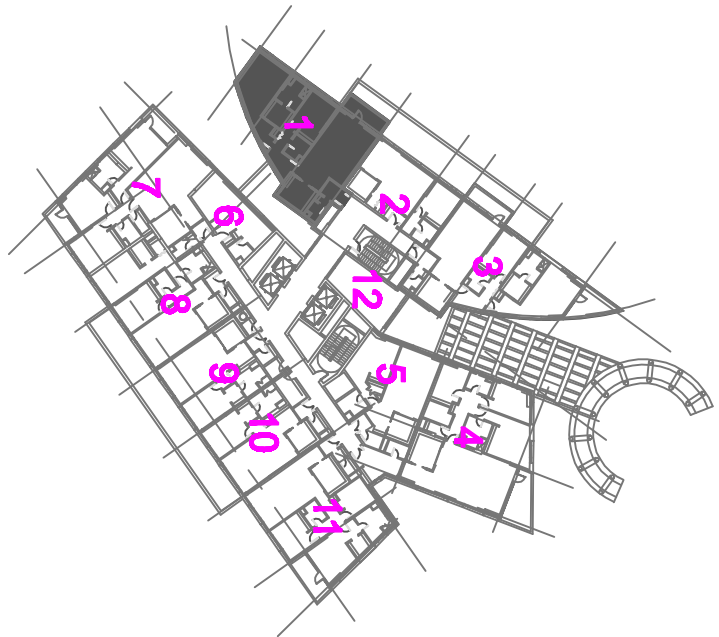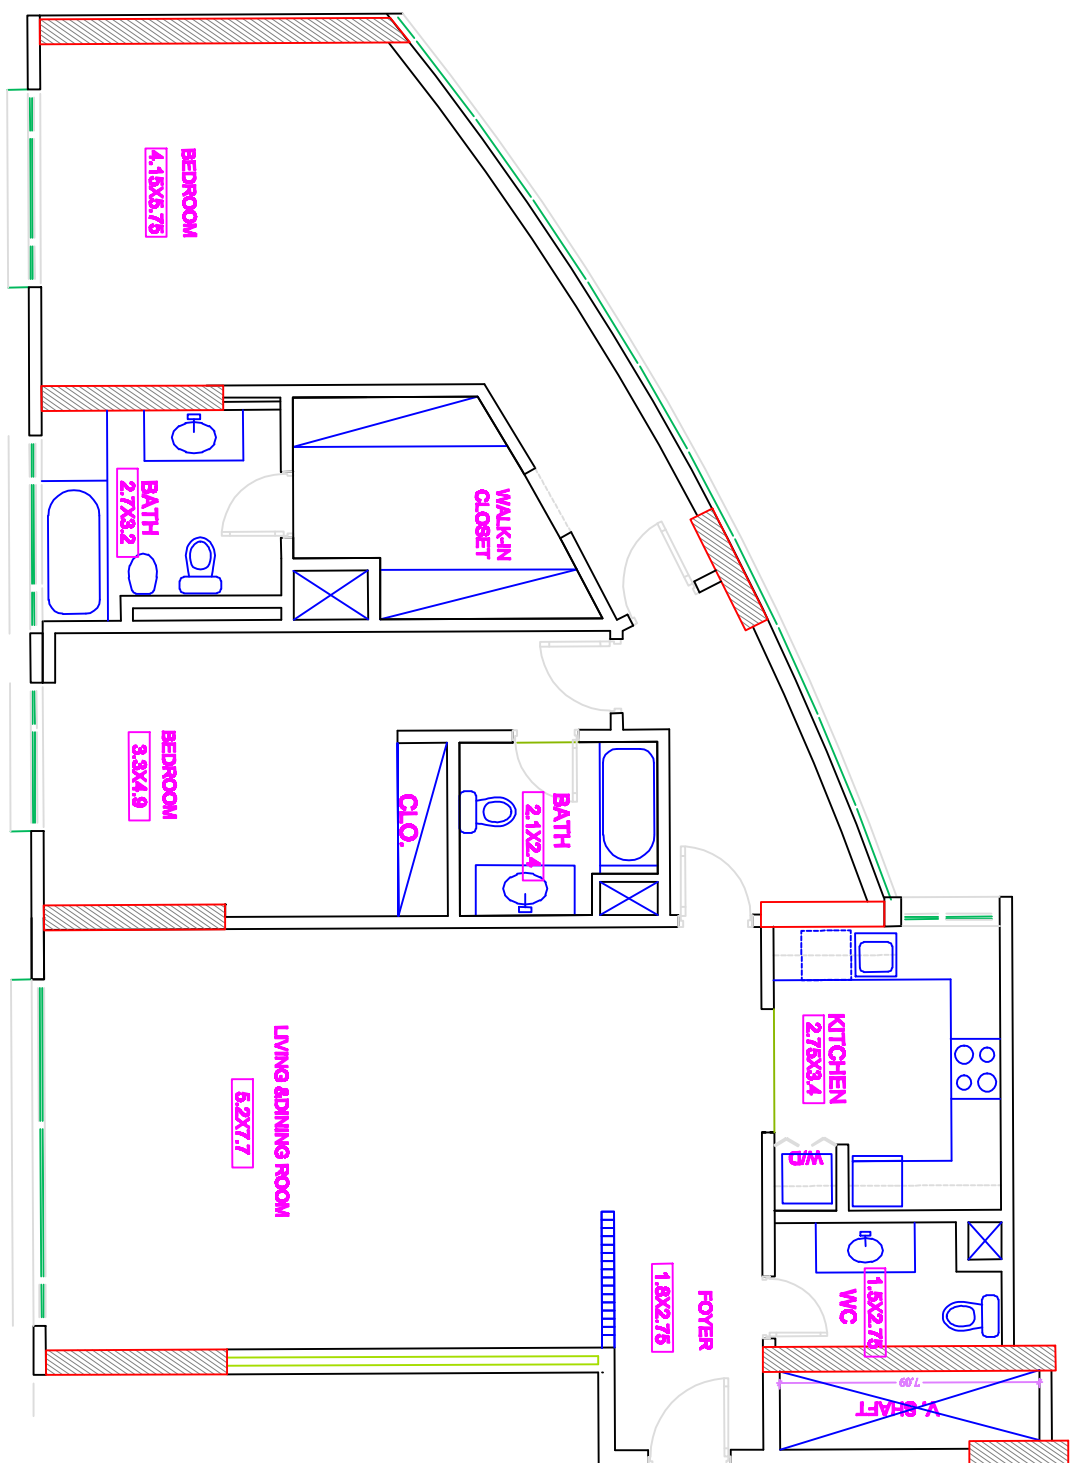

FLAT NO.1
2BEDROOMS