



# FLAT NO.3

## 2BEDROOMS

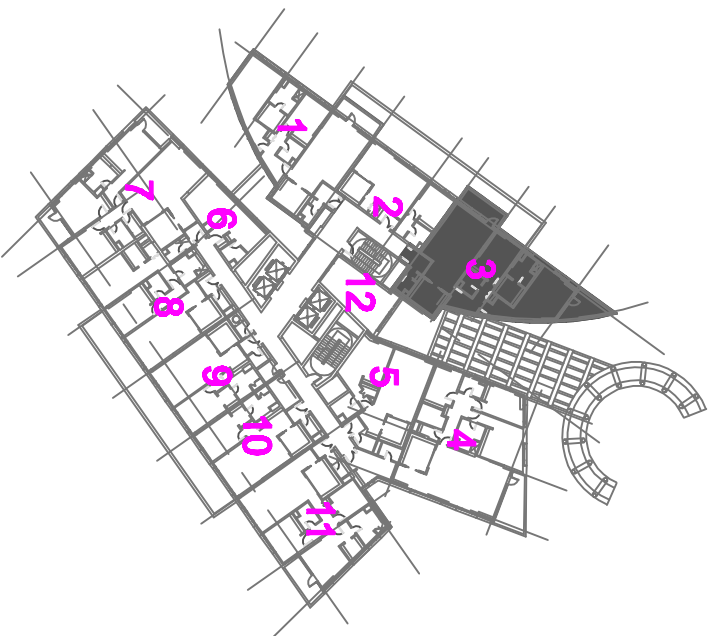

**Project**  
**DANET ABU DHABI**  
 PLOT No. 43  
 ABU DHABI  
 UNITED ARAB EMIRATES

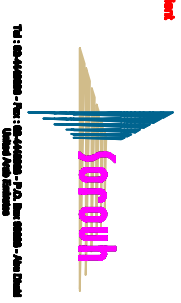

**Client**  
 NES  
 Project No.:  
 Project manager:

**Consultant**  
**ZNA**  
 ZETSEKODLU NAYYAN ASSOCIATES, INC.  
 ARCHITECTS, URBAN DESIGNERS

**CRJIA**  
 CAROL F. JOHNSON ASSOCIATES INC.

**Main contractor:**  
 NPCC-BCEG JV

- Concrete wall
- Hollow block wall
- 1HR FIRE RATED WALL
- 2HR FIRE RATED WALL

# AS BUILT

## FLAT NO.3

Scale	N.T.S	Date	28/10/08
Drawn	M.Fahad	Checked	Aliamad
Drawn's Title:			

**Drawing Number:**