


Project
DANET ABU DHABI
 PLOT No. 43
 ABU DHABI
 UNITED ARAB EMIRATES

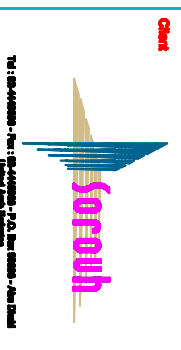


Client Project No.:
Project manager:
NES
 شركة نيس
 مهندسين ومهندسات
 رقم ترخيص المهندس رقم 02-150184 / رقم ترخيص المهندسات

Consultants
ZNA
 ZENBERKOLU NAYMAN ASSOCIATES, INC.
 ARCHITECTS, INTERIORS DESIGNERS

CRJIA
 CAROL A. JOHNSON ASSOCIATES INC.


Main contractor:
NPC
 NPC-BCEG JV

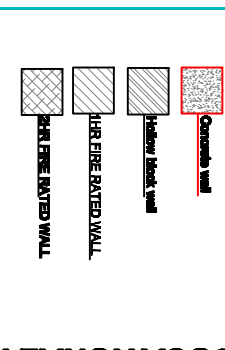

AS BUILT
FLAT NO.11

Scale	N.T.S	Date	28/10/09
Drawn	M.Fahad	Checked	Amjed
Drawing Title:			

Drawing Number:

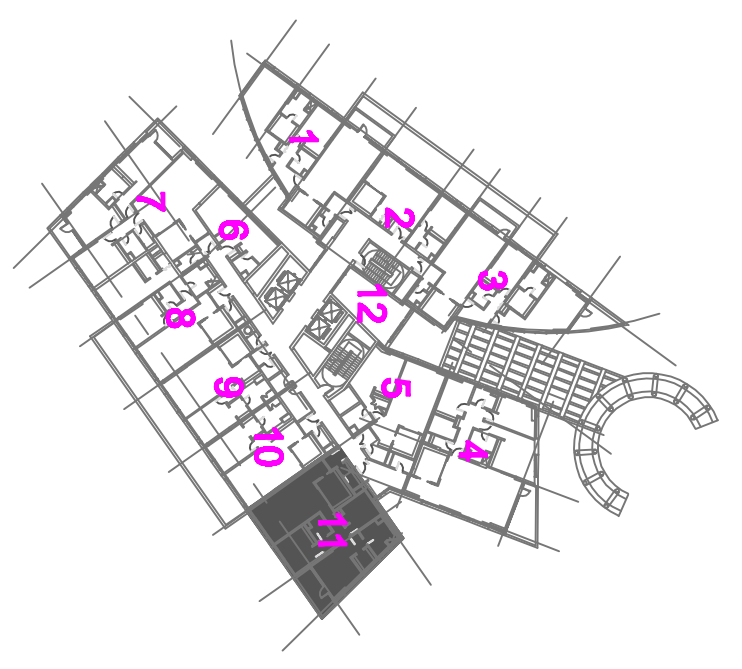

FLAT NO.11
3BEDROOMS