


Project
DANET ABU DHABI
 PLOT No. 43
 ABU DHABI
 UNITED ARAB EMIRATES

Client

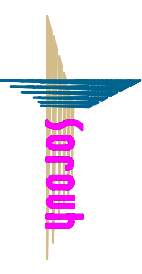

Tel : 02-4400000 - Fax : 02-4400000 - 24/7 Hot Lines - Abu Dhabi
 (United Arab Emirates)

Client Project No.:

Project manager:

NES شركة نيس
 "NESA ENGINEERING SERVICES" P.O. BOX 2450198 / P.O. BOX 443000 / DUBAI

Consultants



ZNA
 ZENBERKOGULI NAYMAN ASSOCIATES, INC.
 ARCHITECTS, INTERIOR DESIGNERS



C R J I A
 CAROL & JOHNNY ASSOCIATES INC.

Main contractor:

NPC
 NPC-BCEG JV

www.npc-bceg.com
 www.npc-bceg.com



Concrete wall



Insulated wall



1HR FIRE RATED WALL




2HR FIRE RATED WALL

AS BUILT
FLAT NO.12

Scale	N.T.S	Date	28/10/09
Drawn	M.Fahad	Checked	Amjed
Drawing Title:			

Drawing Number:

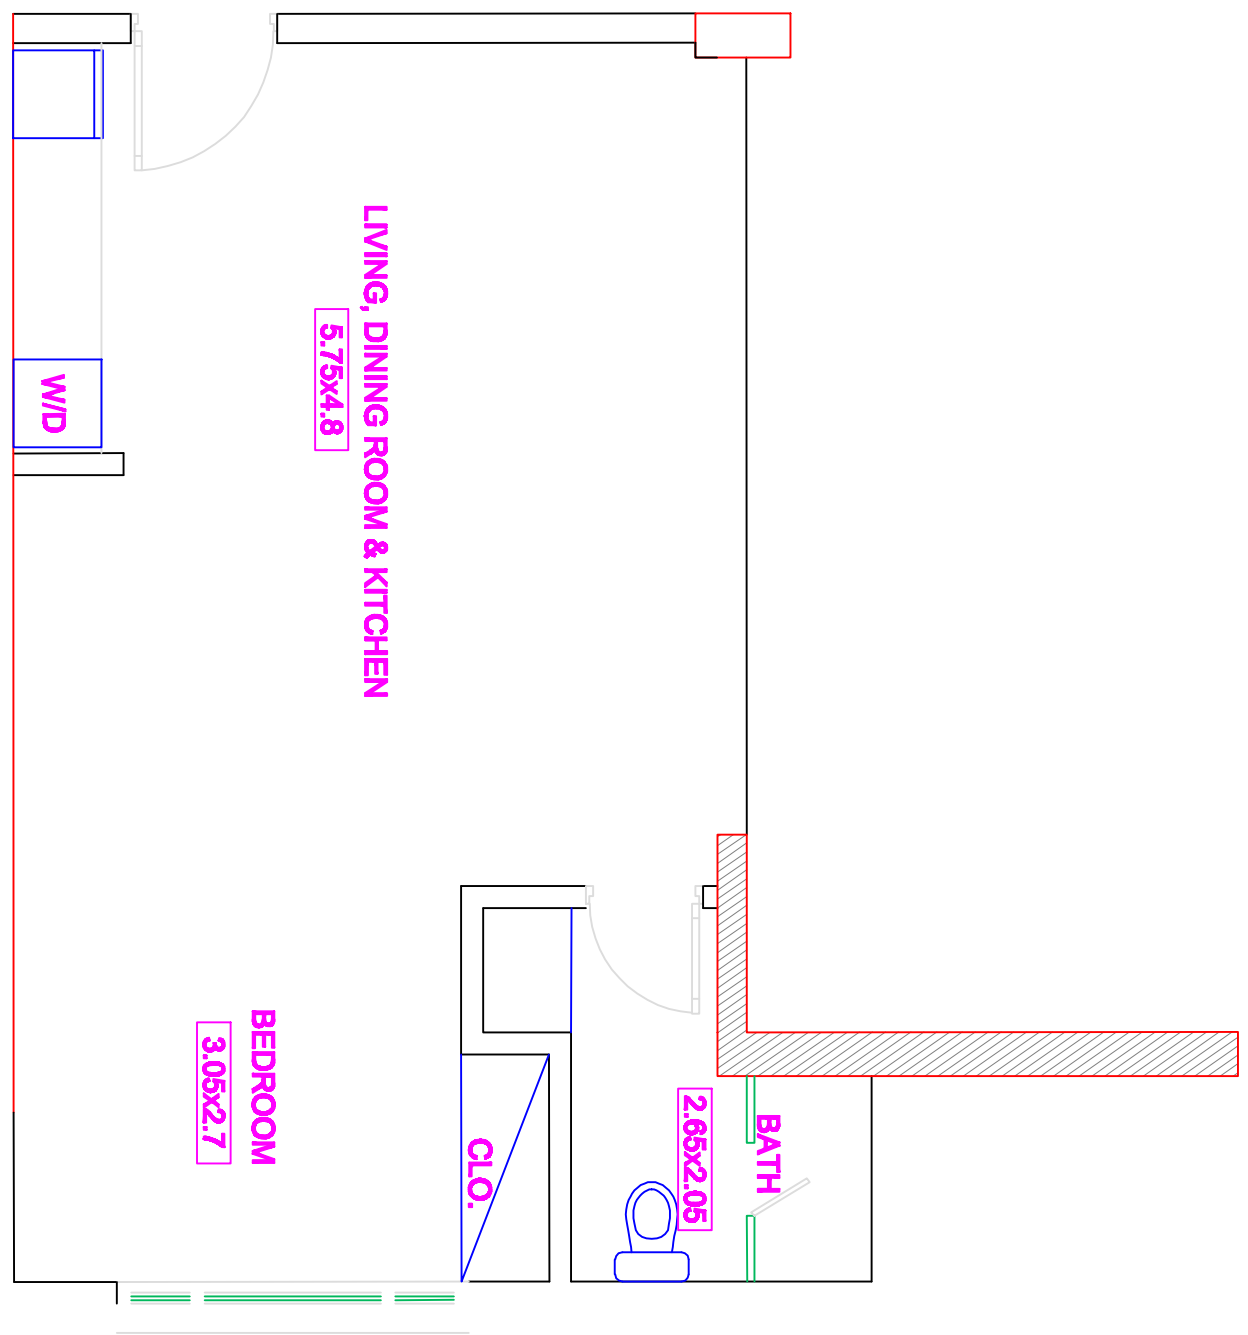

FLAT NO.12
STUDIO

